

B

JACKSON - SURVEYORS


REGISTERED UNDER LAWS OF STATE OF MINNESOTA

3018 EAST 55th STREET, MINNEAPOLIS, MN 55417 727-3484

Surveyor's Certificate

S.E. 1/4 - N.W. 1/4
Sec. 19

Scale: 1" = 300'

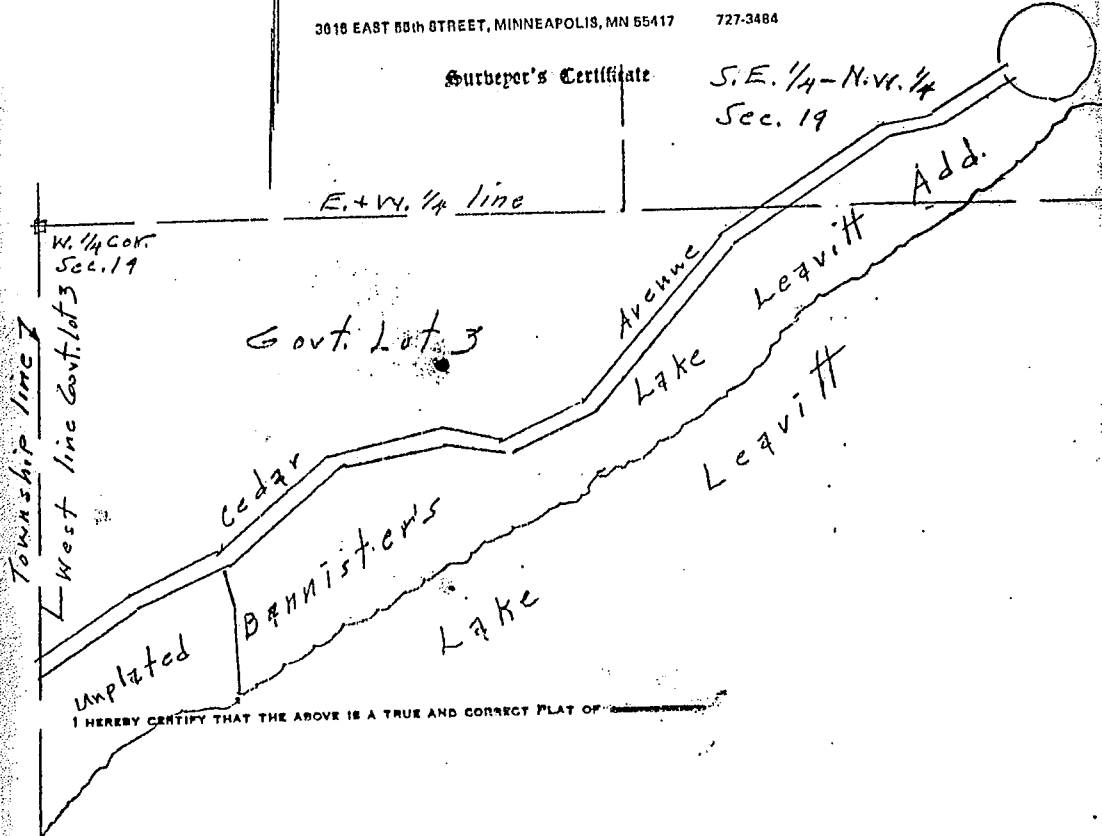

I HEREBY CERTIFY THAT THE ABOVE IS A TRUE AND CORRECT PLAT OF

A Township Road known as Cedar Avenue, in Government Lot 3 and the Southeast 1/4 of the Northwest 1/4, Section 19, Township 139, Range 25, as laid out in the plat of BANNISTER'S LAKE LEVITT ADDITION, according to the plat thereof on file and of record in the Office of the Register of Deeds in and for the County of Cass, State of Minnesota.

THIS 28th. DAY OF July A.D. 1984.

SIGNED: *F. C. Jackson*
F. C. JACKSON, MINNESOTA REGISTRATION No. 3600

RECEIVED
#455
SEP 6 2000
F/AUB.
COUNTY SURVEYOR

