

432814

OFFICE OF COUNTY RECORDER

State of Minnesota, County of Cass  
I hereby certify that the within instrument  
was filed in this office for record on the  
8 day of Feb. A.D. 20 01  
at 9:00 O'clock A M and was duly  
recorded as Micro Doc. No. 432814

*Claudia Kayler*  
COUNTY RECORDER


J-5

**CERTIFICATE OF LOCATION OF GOVERNMENT CORNER**

NORTHEAST Corner of Section 18, Township 133, Range 30  
5 TH Principal Meridian, State of Minnesota, County of CASS

At the corner location shown on the sketch:

- On 6-16-99 found a CAST IRON MONUMENT  
DATE
- left monument as found     lowered monument     removed monument (explain)
- On \_\_\_\_\_ placed a \_\_\_\_\_  
DATE

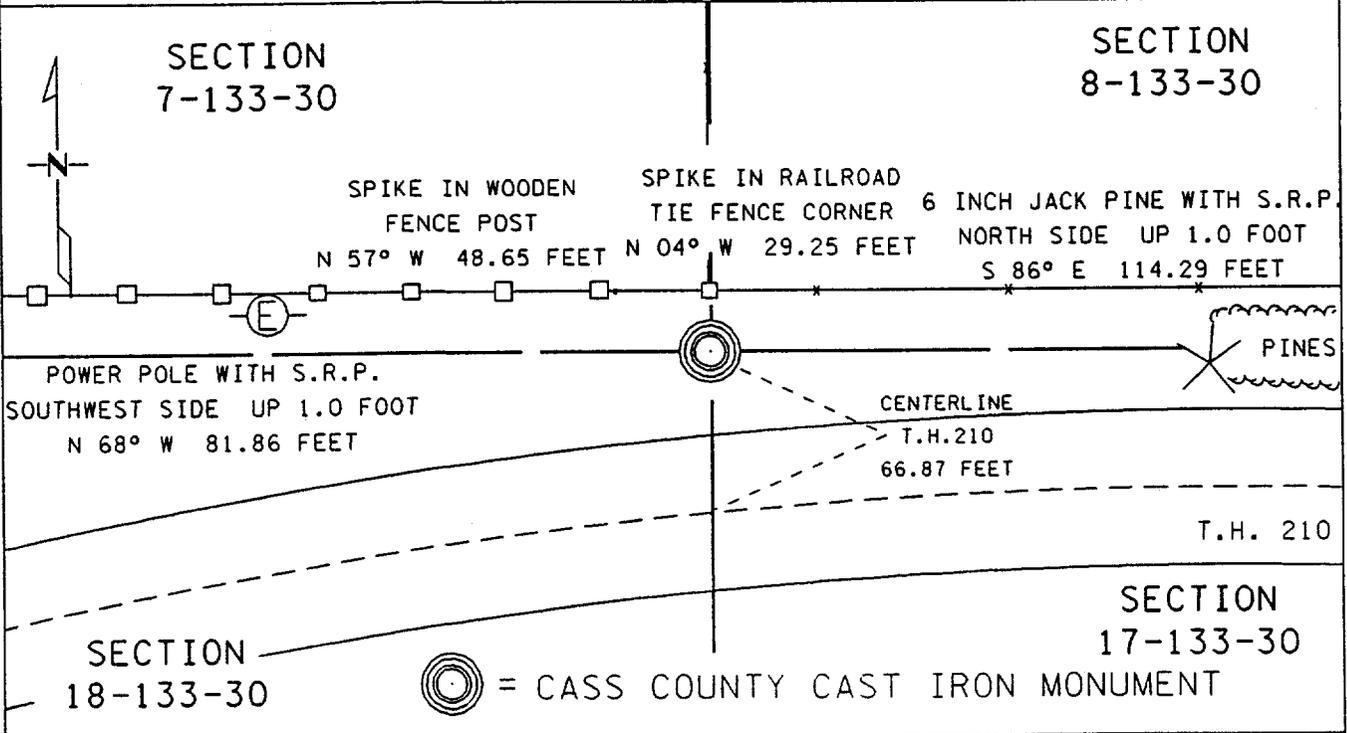

Statement of evidence for this corner location is on back of this page.

I hereby certify that this document was researched and prepared by me or under my direct supervision.

Signature *James K...* Date 1-1-2001 License No. 23668  
 Title:  Land Surveyor     Professional Engineer     County Surveyor     County Engineer

Statement of Evidence: Northeast Corner Section 18, Township 133 North, Range 30 West,  
5<sup>th</sup> Principal Meridian, Cass County, Minnesota.

The original public land survey was run in 1870, and a wood post was set to mark the corner. Bearing tree ties were made to four black pines.

In 1984, Comstock and Davis set a Cass County Cast Iron Monument 68.5 feet north of centerline of Trunk Highway 210. Bearing ties were established to a jack pine, a power pole, and two wood fence posts ( Doc. Number 276575 ).

On June 16,1999, The Minnesota Department of Transportation recovered a Cast Iron Monument and the two wooden fence post ties from 1984. Additional bearing ties were made to a jack pine and a power pole. The Minnesota Department of Transportation accepts this position as the correct location for the corner.

For details and survey analysis, contact the Minnesota Department of Transportation District Surveys Office in Baxter, Minnesota.