

432818

OFFICE OF COUNTY RECORDER

State of Minnesota, County of Cass
I hereby certify that the within instrument
was filed in this office for record on the
8 day of Feb A.D. 20 01
at 9:40 O'clock A M and was duly
recorded as Micro Doc. No. 432818

Claudia Kayser
COUNTY RECORDER *for*


J-13

CERTIFICATE OF LOCATION OF GOVERNMENT CORNER

NORTHEAST Corner of Section 16, Township 133, Range 30
5 TH Principal Meridian, State of Minnesota, County of CASS

At the corner location shown on the sketch:

- On 6-16-99 found a 3 INCH IRON PIPE FILLED WITH CONCRETE
DATE
- left monument as found lowered monument removed monument (explain)
- On _____ placed a _____
DATE

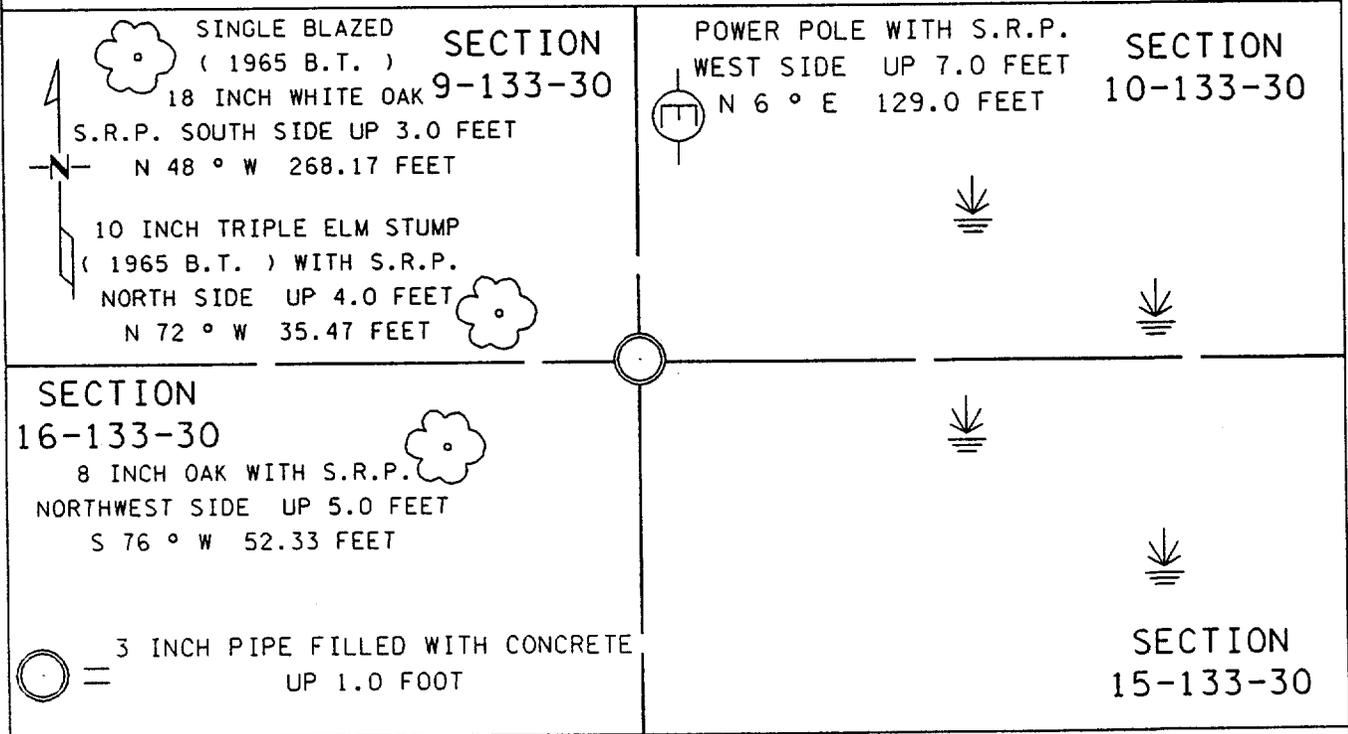

Statement of evidence for this corner location is on back of this page.

I hereby certify that this document was researched and prepared by me or under my direct supervision.

Signature James Kramer Date 1-11-2001 License No. 23668
Title: Land Surveyor Professional Engineer County Surveyor County Engineer

Statement of Evidence: Northeast Corner Section 16, Township 133 North, Range 30 West,
5th Principal Meridian, Cass County, Minnesota.

The original public land survey was run in 1870, and a wood post was set to mark the corner. Bearing tree ties were made to two black pines and a Norway pine.

In 1911, Mr. John Curo set a three inch by 36 inch iron pipe filled with concrete from the original Norway B.T. (down).

In 1942, Mr. John Curo made bearing ties to a red oak, a white oak, a jack pine, and an iron bar.

In 1965, Mr. R.F. Schneider established ties to a jack pine, a white oak, and a triple elm. (Book D, Page 472, County Surveyor's Office)

On June 16, 1999, The Minnesota Department of Transportation recovered the three inch iron pipe filled with concrete and two 1965 Bearing Trees. Additional bearing ties were made to a power pole and an oak. The Minnesota Department of Transportation accepts this position as the correct location for the corner.

For details and survey analysis, contact the Minnesota Department of Transportation District Surveys Office in Baxter, Minnesota.