

A000509692

OFFICE OF COUNTY RECORDER
CASS COUNTY MINNESOTA

CERTIFIED, FILED, AND/OR
RECORDED ON
02/08/2006 11:46:31AM

AS DOC #: A000509692
PAGES: 2
REC FEES: \$0.00

KATHRYN M. NORBY
COUNTY RECORDER


BY *Kathryn M. Norby*
DEPUTY

CERTIFICATE OF LOCATION OF GOVERNMENT CORNER

East Quarter Corner of Section 36, Township 138, Range 30
West Principal Meridian, State of Minnesota, County of Cass

At the corner location shown on the sketch:

- On 3/24/05 found a 1' Iron pipe monument
DATE
- left monument as found lowered monument removed monument (explain)
- On _____ placed a _____
DATE

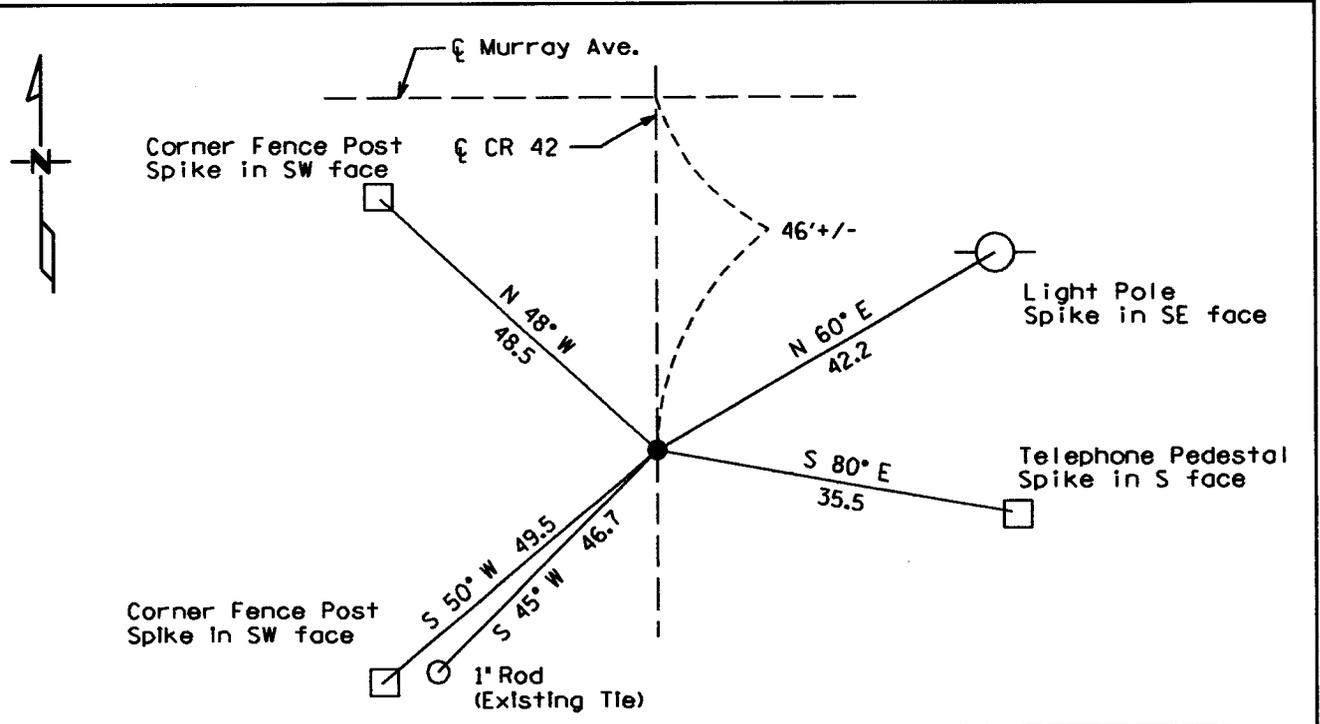

Statement of evidence for this corner location is on back of this page.

I hereby certify that this document was researched and prepared by me or under my direct supervision.

Signature: *Janet [unclear]* Date: 2/28/05 License No. 42619

Title: Land Surveyor Professional Engineer County Surveyor County Engineer

Statement of Evidence:

East Quarter Corner Section 36, Township 138 North, Range 30 West.

The Original Public Land Survey was run in 1865 and a wood post was set to mark the corner. Bearing tree ties were made to a Norway Pine and a Black Pine.

In 1910 Mr. John Curo set a 12d spike. Bearing trees stumps from the Original Public Land Survey were recovered. An additional tie was made to a Fence Post.

In 1911 Mr. A.W. Moulster recovered a monument.

In 1913 Mr. John Curo shows monument recovered in the plat of Sixth Addition to Pine River.

In 1979 the Cass County Highway Department recovered a 1" iron pipe monument. Bearing tree ties were made to a Power Pole, a Post and a 1" rod.

In 2005 Kramer Leas DeLeo recovered a 1" iron pipe monument and made bearing tree ties to two fence posts, a light pole, a telephone pedestal and recovered the 1" rod tied to by the Cass County Highway Department in 1979. Kramer Leas DeLeo accepts this position as the correct location for the corner.

For details and survey analysis contact Kramer Leas DeLeo in Baxter, Minnesota.