

A000516669

OFFICE OF COUNTY RECORDER
CASS COUNTY MINNESOTA

CERTIFIED, FILED, AND/OR
RECORDED ON
08/16/2006 12:39:07PM

AS DOC #: A000516669
PAGES: 2
REC FEES: \$0.00

KATHRYN M. NORBY
COUNTY RECORDER

BY Kathryn M. Norby ^{AV} DEPUTY

CERTIFICATE OF LOCATION OF GOVERNMENT CORNER

East Quarter Corner of Section 6, Township 138 N, Range 30 W


5TH Principal Meridian, State of Minnesota, County of Cass

At the corner location shown on the sketch:

On 3-20-2005 found a 1/2" Rebar
DATE

left monument as found lowered monument removed monument (explain)

On _____ placed a _____
DATE

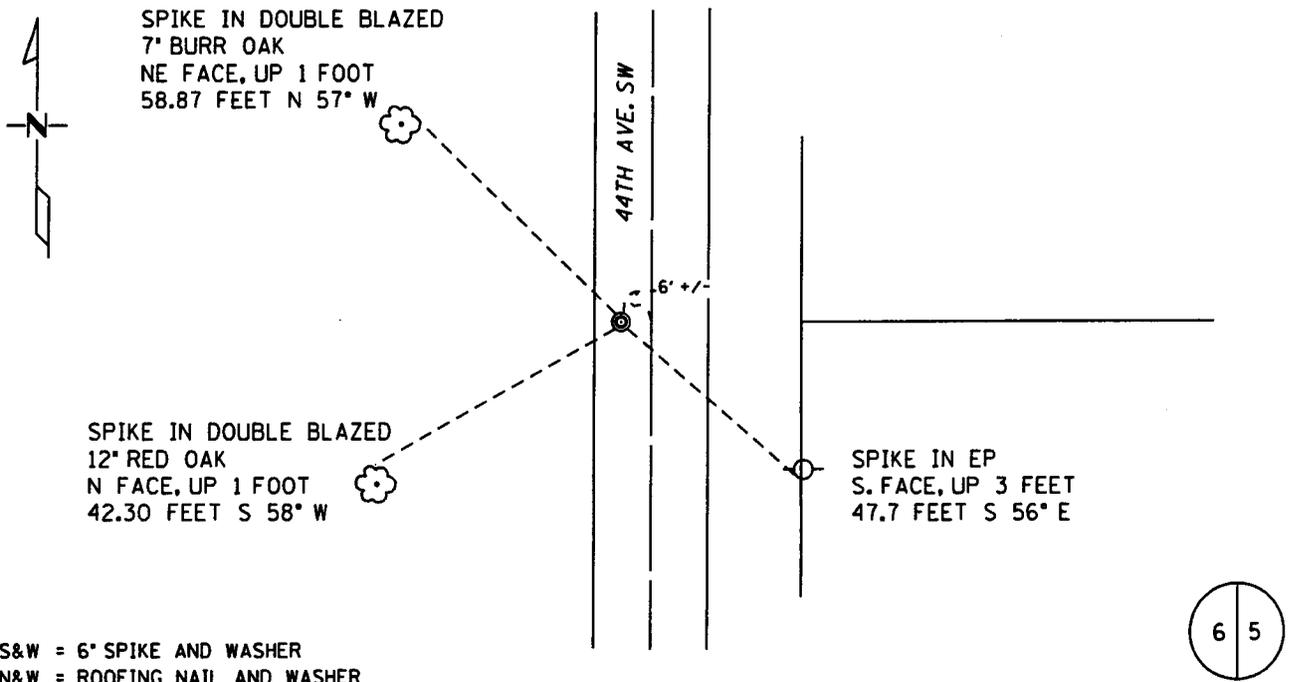

Statement of evidence for this corner location is on back of this page.

I hereby certify that this document was researched and prepared by me or under my direct supervision.

Signature [Signature] Date 3/14/06 License No. 42619
Title: Land Surveyor Professional Engineer County Surveyor County Engineer

Statement of Evidence: East Quarter Corner of Section 6, Township 138, Range 30 West, 5th Principle Meridian, Cass County Minnesota.

The Original Government Survey was run in 1865 and a post was set to mark the corner. Bearing ties were made to two Black Pine trees.

In 1920, Mr. Ben Clark recovered the post and bearing ties. A 2.5 x 30 inch iron monument was set.

In 1921, Mr. E.B. Horst recovered an iron monument in place.

In 1924, the Minnesota Highway Department recovered the iron pipe monument.

In 2006 Kramer Leas DeLeo recovered a ½" rebar monument and made bearing tree ties to two oak trees and a power pole. Kramer Leas DeLeo accepts this as the correct location for the corner.

For details and survey analysis contact Kramer Leas DeLeo in Brainerd, Minnesota.