

CERTIFICATE OF LOCATION OF GOVERNMENT CORNER

EAST QUARTER Corner of Section 28, Township 135N., Range 32W., 5th P.M.


STATE OF MINNESOTA, County of CASS

At the corner location shown on the sketch:

- On _____ found a _____
 - left monument as found
 - lowered monument
 - removed monument(explain)
- On 11/10/2010 placed a 1" DIA. IRON PIPE CAPPED "PLS 13620 & 17825" IN AN 18 INCH HIGH, 3 FOOT SQUARE MOUND FOUND IN A WETLAND

SKETCH OF REFERENCE TIES

COORDINATES LISTED FOR THE SECTION CORNERS ARE BASED ON CASS COUNTY COORDINATES SOUTH ZONE- 1996 ADJUSTMENT - AS DETERMINED BY THE MNDOT CORS/VRS NETWORK

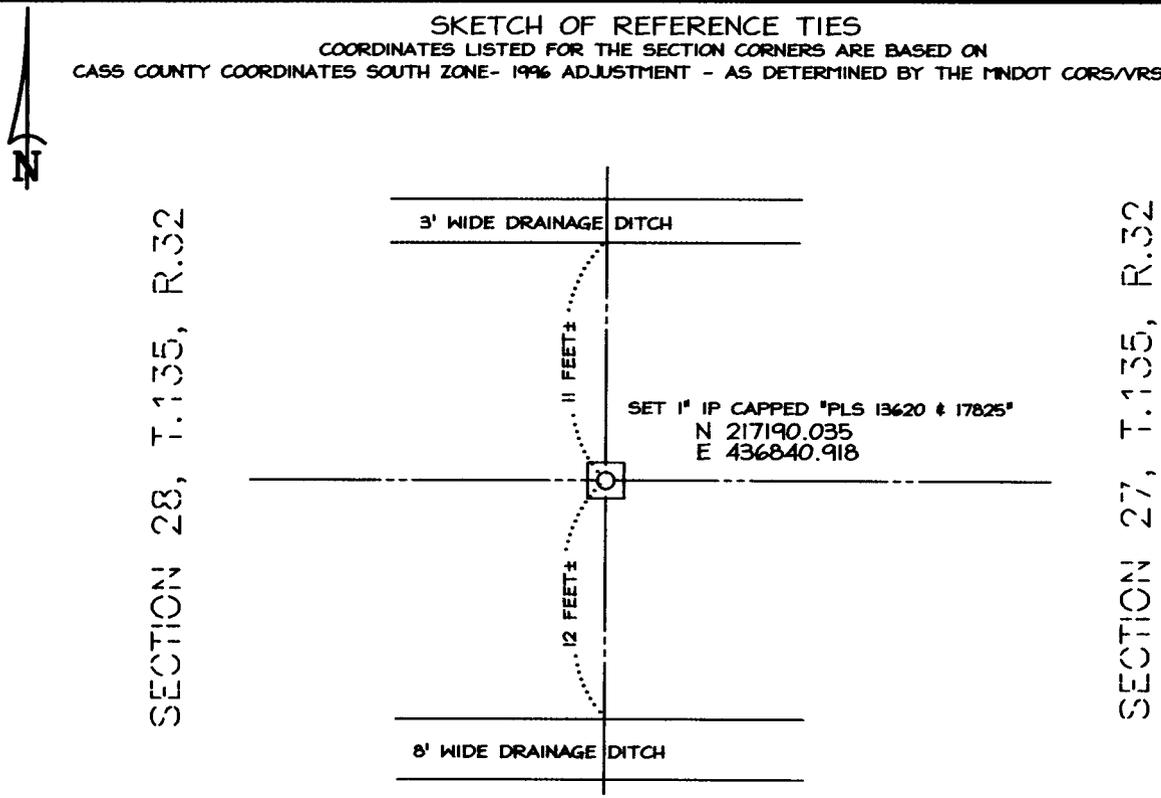

ALS - 214/16
SKETCH NOT TO SCALE

STATEMENT OF EVIDENCE RELATIVE TO THIS CORNER LOCATION IS ON BACK OF PAGE

I hereby certify that this document and the data contained herein was prepared by me or under my direct supervision.

David A. Anderson
 DAVID A. ANDERSON
 Professional Land Surveyor
 Minn. Reg. No. 13620

3/3/2011
Date

OFFICE OF COUNTY RECORDER
COUNTY OF CASS

I hereby certify that the within instrument was filed in the office for record on the _____ day of _____ A.D., 20____ at _____ o'clock _____ M. and was duly Microfilmed as document no. _____ County Recorder _____ By _____ Deputy



East Quarter Corner of Section 28, Township 135 North, Range 32 West

The following offices were contacted for information on this corner:

Cass County Auditor's Office
Cass County Recorder's Office
Cass County Surveyor's Office
Wadena County Recorder's Office
Wadena County Highway Department
Minnesota Department of Natural Resources
Minnesota Department of Transportation
Sunde Land Surveying, Inc.
Meadowland Surveying, Inc.
Westwood Professional Services, Inc.
Files and records of Anderson Land Surveying, Inc.

In 1866, Oscar E. Garrison, GLO Deputy Surveyor, set post for the corner and made a reference tie to a 5" Tamarac. This corner was located in a Tamarac swamp.

In 1915, R.E. Bryant, Deputy Cass County Surveyor, in County Surveyor's Survey Record No. 570, set a temporary post for this corner, however the survey is labeled incorrect survey, see Horst's Resurvey.

In 1915 and 1916, E.B Horst, Deputy Cass County Surveyor, in County Surveyor's Survey Record No. 382, set a 1-1/2 inch iron pipe for this corner, using proportionate measurements.

In October, 2010, I made thorough search of area. I did not find any evidence of Horst's monument. I found an 18 inch high, 3 foot square man made mound, 3.9 feet west and 1.1 feet north of a proportionate measurement position in a wetland area. I believe that ~~that~~ the mound was built to mark the corner. I placed a 1 inch pipe capped "PLS 13620 & 17825" in the mound. This position fits GLO distances very closely. Cass County coordinates for this corner are noted on page 1.

For further information contact David A. Anderson, PLS of Anderson Land Surveying, Inc. of Fergus Falls, MN.

A000572892
OFFICE OF COUNTY RECORDER
CASS COUNTY MINNESOTA
CERTIFIED, FILED, AND/OR
RECORDED ON
08/22/2011 1:14:56 PM
AS DOC #: A000572892
PAGES: 2 REC FEES: 0.00
KATHRYN M. NORBY
COUNTY RECORDER