

CERTIFICATE OF LOCATION OF GOVERNMENT CORNER

NE Corner of Section 5, Township 133N, Range 29W, 5th p.m., State of Minnesota, County of Cass


At the corner location shown on the sketch:

On MAY 20, 2015 found a 3/8" X 1" IRON BAR, BURIED 2 FT BELOW BITUMINOUS
Date

Xleft monument as found lowered monument removed monument (explain)

On _____ placed a _____
Date

SKETCH OF REFERENCE TIES

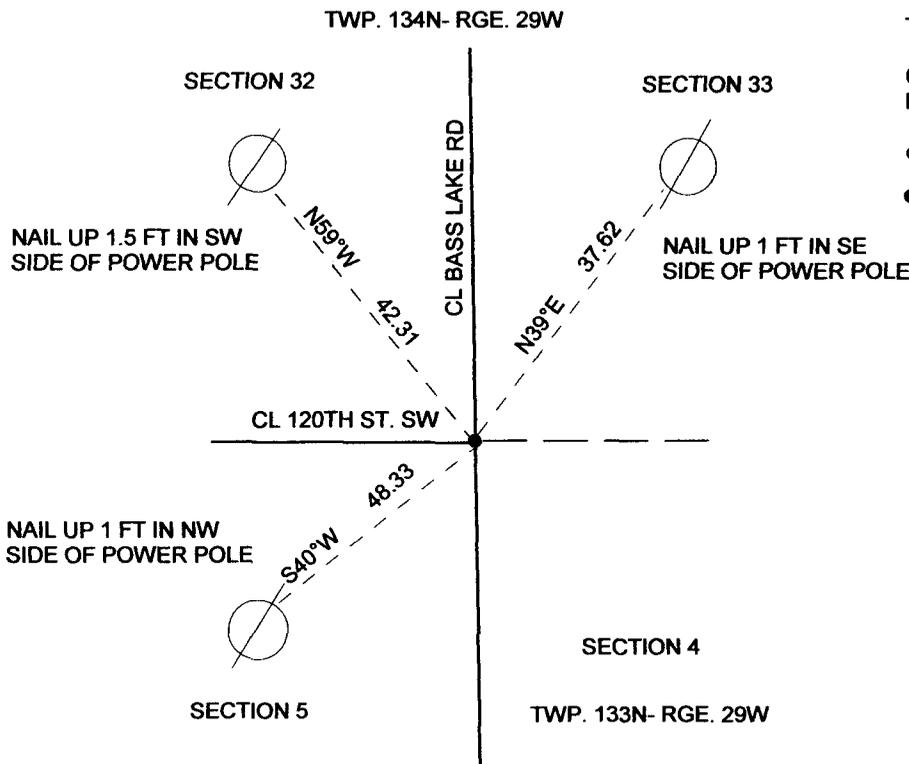

Tie Distances are measured to the spikes.

Cass County Coordinate System (South Zone)
N= 177598.95 E= 529676.03

o Set Re-Rod with RLS cap No. 17774

● Found Iron

NAIL UP 1.5 FT IN SW
SIDE OF POWER POLE

NAIL UP 1 FT IN SE
SIDE OF POWER POLE

NAIL UP 1 FT IN NW
SIDE OF POWER POLE

NOT TO SCALE

Statement of evidence relative to this corner location is on back of page.

I hereby certify that this document and the data contained herein was prepared by me or under my direct supervision.

Marvin R Kohout 6 Oct 2015
Marvin R. Kohout Date

License No, 17774

Land surveyor

OFFICE OF COUNTY RECORDER



A000616513

OFFICE OF THE COUNTY RECORDER
CASS COUNTY, MINNESOTA
CERTIFIED, FILED, AND/OR
RECORDED ON

10/22/2015 1:58:46 PM

AS DOC #: A000616513

PAGES: 3

REC FEES: 0.00

KATHRYN M. NORBY
CASS COUNTY RECORDER

BY SR _____ Dep TX#: 126608

Page 1 of 3
A000616513



STATEMENT OF EVIDENCE

NORTHEAST CORNER OF SECTION 5, TOWNSHIP 133N, RANGE 29W, 5TH P.M.

- 1858 DEPUTY SURVEYOR EHUD NOBLE DARLING IN THE ORIGINAL GOVERNMENT SURVEY SET A POST AND MARKED B.T.'S REFERENCES ARE:
12" PINE N30E 219 LKS 13' PINE N22 1/2W 197 LKS 13" PINE S63 1/4W 545 LKS
RECORDS ON FILE AT THE MN HISTORICAL SOCIETY, ST. PAUL, AND COPIES
FILED WITH CASS COUNTY HIGHWAY DEPARTMENT/ SURVEYOR'S OFFICE
(CCHD/SO).

- 1921 JOHN GREEN, COUNTY SURVEYOR, SET A WOOD STAKE PROPORTIONALLY
COUNTY BOOK "C" PAGE 451 CCHD/SO

- 1922 DEPUTY COUNTY SURVEYOR E.B. HORST LS NO. 376, STATED THAT HE
BEGAN SURVEY AT I.M. AT THE NW CORNER OF SECTION 4 (SE 32) AND RAN
SOUTH ON SECTION LINE. CURO BOOK 153, PAGE 80, CCHD/SO.

- 1926 COUNTY SURVEYOR JOHN GREEN STATES THAT HE USED CORNER FOR
POINT OF BEGINNING AND MARKED B.T.'S REFERENCES ARE:
15" OAK N88 14E 64.9' 9" OAK N62 18E 99.6'
COUNTY BOOK "D" PAGE 175, CCHD/SO

- 1998 BRUCE GRIVNA LIC. NO. 17253, CERTIFICATE OF SURVEY SHOWS FOUND
MONUMENT, REFERENCE LOCATION STATEMENT OF EVIDENCE,
DOCUMENT # A000515690, CCHD/SO.

- 2000 J. KRAMER LIC. NO. 23668, CERTIFICATE OF SURVEY SHOWS FOUND
MONUMENT, REFERENCE LOCATION STATEMENT OF EVIDENCE,
DOCUMENT # A000515690, CCHD/SO.

- 2001 J. KRAMER LIC. NO. 23668, ON THE PLAT OF "KINGDOM ACRES" SHOWS
FOUND CORNER. CCSO PLAT BOOK "F", PAGE 69, DOCUMENT NUMBER
452013, CASS COUNTY RECORDER'S OFFICE.

- 2002 J. NIELSON LIC. NO. 11865, CERTIFICATE OF SURVEY SHOWS FOUND
MONUMENT. REFERENCE LOCATION 2082, CCHD/SO.



- 2004 WESTWOOD PROFESSIONAL SERVICES FOUND ½" PIPE IN PLACE,
REFERENCE LOCATION STATEMENT OF EVIDENCE, DOCUMENT #
A000515690, CCHD/SO.
- 2015 MARVIN KOHOUT LS NO. 17774 AND TRAVIS BARE, TECHNICIAN, OF
KOHOUT LAND SURVEYING FOUND A 3/8" X 1" IRON BAR ABOUT TWO FEET
BELOW BITUMINOUS SURFACE. ACCEPTED MONUMENT AS MARKING THE
LOCATION OF THE NE CORNER.