OFFICE OF THE COUNTY RECORDER CASS COUNTY, MINNESOTA CERTIFIED, FILED, AND/OR RECORDED ON

10/23/2024 8:46:49 AH

AS DOC #: A000706836 Pages: 1


REC FEEF: 0.00

BY EA Dep TX#: 199916

I hereby certify that this survey, plan, or report was was prepared by me or under my direct supervision and that I am a duly Licensed Land Surveyor under the laws of the state of Minnesota.

Anuch 22October 2014

Daniel J. McAninch MN LIC.# 25684

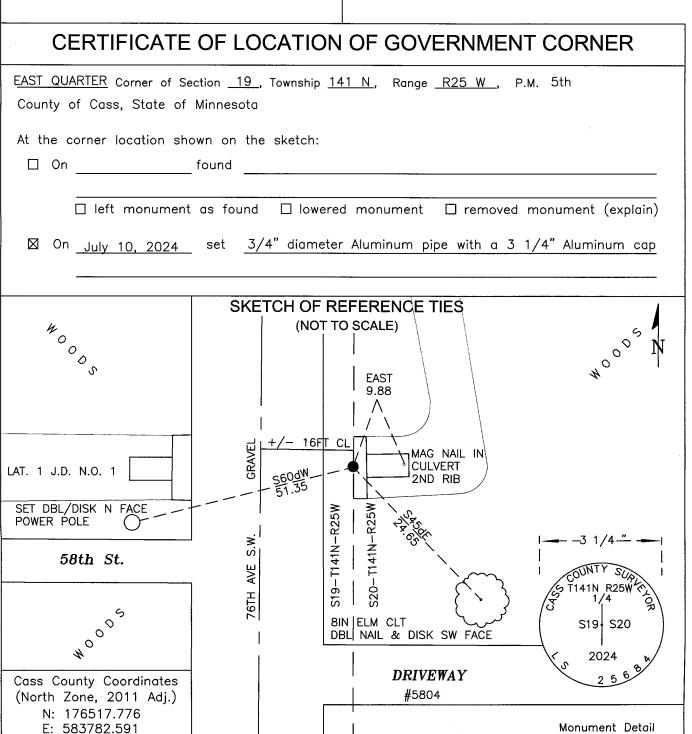

## STATEMENT OF EVIDENCE:

EAST QUARTER CORNER OF SECTION 19 TOWNSHIP 141 NORTH, RANGE 25 WEST, (former LIMA TWP.), CASS COUNTY MINNESOTA

During the original survey of Township 141 North, Range 25 West, a wood post was set, by a GLO crew under William P. Allen and Edgar P. Putnam, to mark the corner. The bearing ties were set. Copies on file in the Cass County Highway Department/Surveyors office. (CCHD/SO).

8" Jack Pine

S84d30'W

35 links (23.1')

10" Norway Pine

N21dE

15 links (9.9')

- 1912 A MAP OF JUDICIAL DITCH No. 1, CASS AND AITKIN COUNTIES shows ditches constructed along the east line of the northeast quarter of Section 19 and also the East-West quarter line.
- Ben F. Clark, found some resurvey bearing trees, set a post at this corner in the "ditch dump" and surveyed southerly. He measured 2619.9 to the corner of sections 19-20-29 and 30.
- A Cass County Survey crew set a monument at a position determined by using the Ditch Map and stationing for Cass- Aitkin Judicial Ditch Number 1 and the as-built location of the roads and ditches to the North and West. Significant research was conducted to deduce the relationship between the section line and improvements. The locations determined from improvements resulted in section line dimensions that matched closely with the stationing shown on the plans.

CASS COUNTY COORDINATES (NAD 83 2011 ADJUSTMENT) N-176517.776 E-583782.591

General Land Office Information on file in the MN historical Society, St. Paul MN. Copies on file in the Cass County Highway Department/Surveyors Office (CCHD/SO).

For additional information contact: Cass County Highway Department County Surveyor's Office 8045 County Road 12 Walker, MN 56484 218-547-1211