

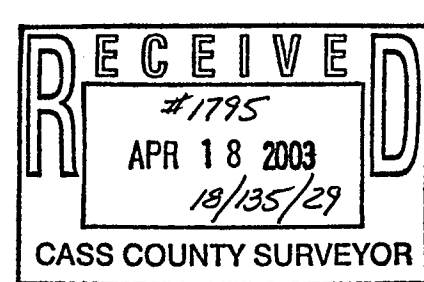


CERTIFICATE OF SURVEY

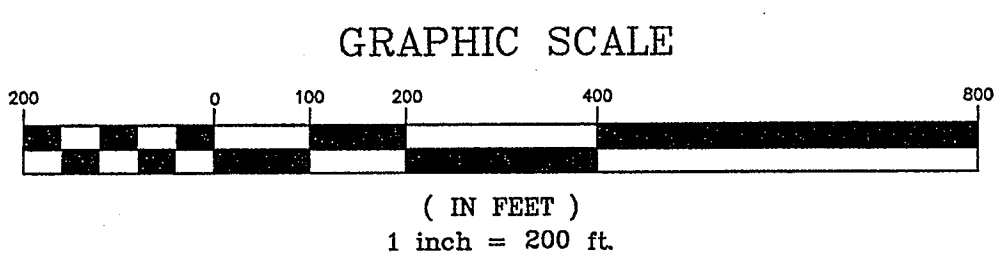

- Denotes Set Iron Monument #17253
- Denotes Found Iron Monument
- △ Denotes set 60d Spike

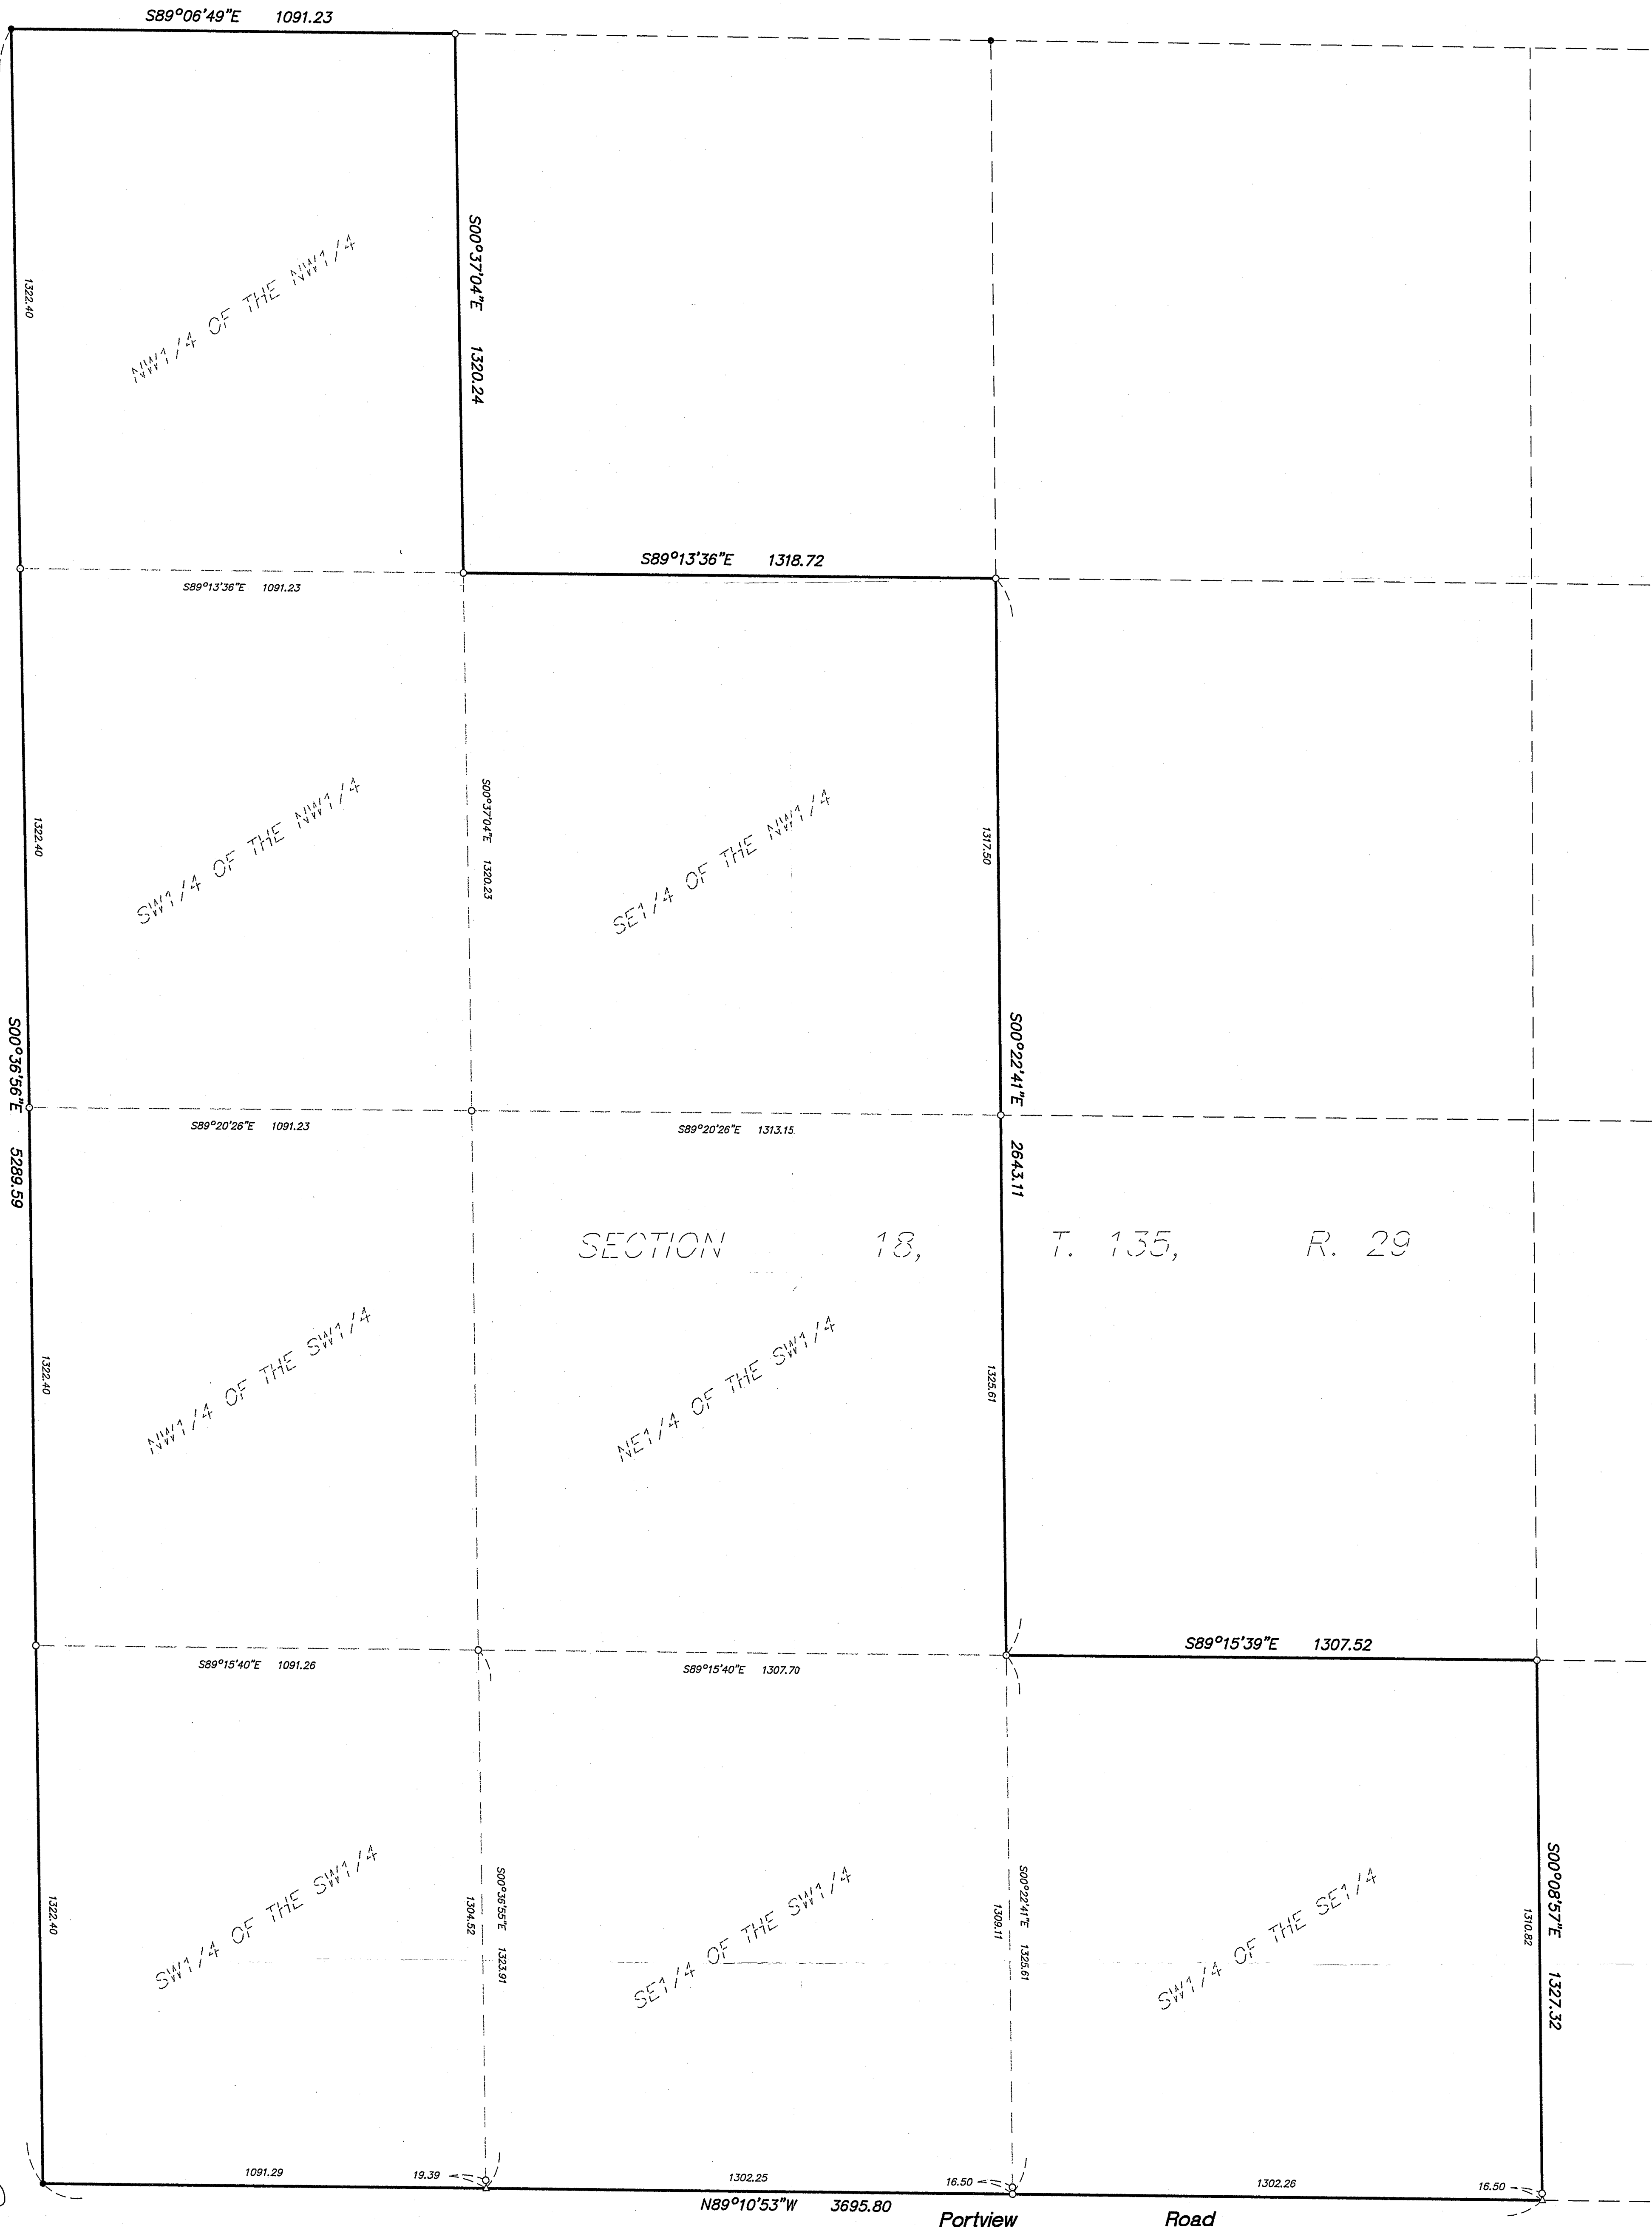

Central Minnesota Surveying
 A division of Westwood Professional Services, Inc.
 411 Laurel Street
 Brainerd, MN 56401 (218) 829-1751

I hereby certify that this survey was prepared by me or under my direct supervision and that I am a duly licensed LAND SURVEYOR under the laws of the State of Minnesota.
 Bruce Grivna
 Date: 4/15/03 License No. 17253

Crew: CH/KW
 Checked: BWG
 Drawn: CDH
 Record Drawing by/date:

Prepared for:
Ernie Rasinski
 10846 Co. Rd. 77 SW
 Nisswa, Minnesota 56468

Part of Section 18
 T135, R29, Cass Co., MN.