


GULL LAKE
 WATER ELEV. = 1193.32 (3/16/04)
 NORMAL POOL ELEV. = 1194.0

LEGAL DESCRIPTION:
 Lots 17 and 18, Block 19, TINGDALE BROS.' SHERWOOD FOREST OF GULL LAKE, according to the recorded plat thereof, Cass County, Minnesota. Subject to easements, reservations and restrictions of record, if any.

NOTE: North line of Lot 17 based on existing iron monuments set by Jim Nielsen R.L.S. No. 11865.

IMPERVIOUS SURFACE
 TOTAL LOT AREA = 29,050± SQ. FT.
 IMPERVIOUS AREA = 3685 SQ. FT.
 3685/29,050± = 13±%

- Denotes Found Pipe
- Denotes Found Pinch Top Iron
- ⊙ Denotes Found Iron Capped #11865 (Nielsen)
- ⊠ Denotes Electric Meter
- ⊙ Denotes Power Pole
- ⊙ Denotes Sewer Cleanout
- ⊙ Denotes Well
- ▨ Concrete Surface
- ▨ Gravel Surface

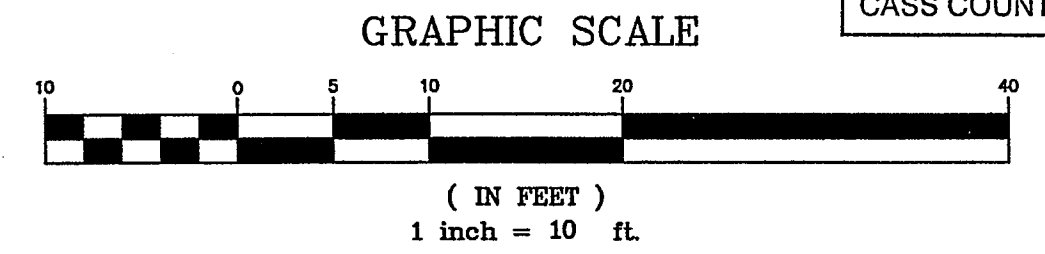

RECEIVED
 GL2 #2230
 JUL - 6 2004
 20-135-29
 CASS COUNTY SURVEYOR

Westwood Professional Services, Inc.
 411 Laurel Street
 Brainerd, MN 56401
 Phone: 218-829-1751 Fax: 218-829-4733

I hereby certify that this plan was prepared by me or under my direct supervision and that I am a duly licensed LAND SURVEYOR under the laws of the State of Minnesota.
 Bruce Grava
 Date: 4/7/04 License No. 17253

Revisions:

Crew: PH/KV
 Checked: BWG
 Drawn: CDH
 Record Drawing by/date: _____

Prepared for:

Randy Arneson
 c/o Jim Christensen
 P.O. Box 779-23590 Smiley Road
 Nisswa, Minnesota 56468

Certificate of Survey
 Lake Shore, Minnesota

Lots 17-18, Blk 19, TINGDALE BROS.' SHERWOOD FOREST ON GULL LAKE