


CERTIFICATE OF SURVEY

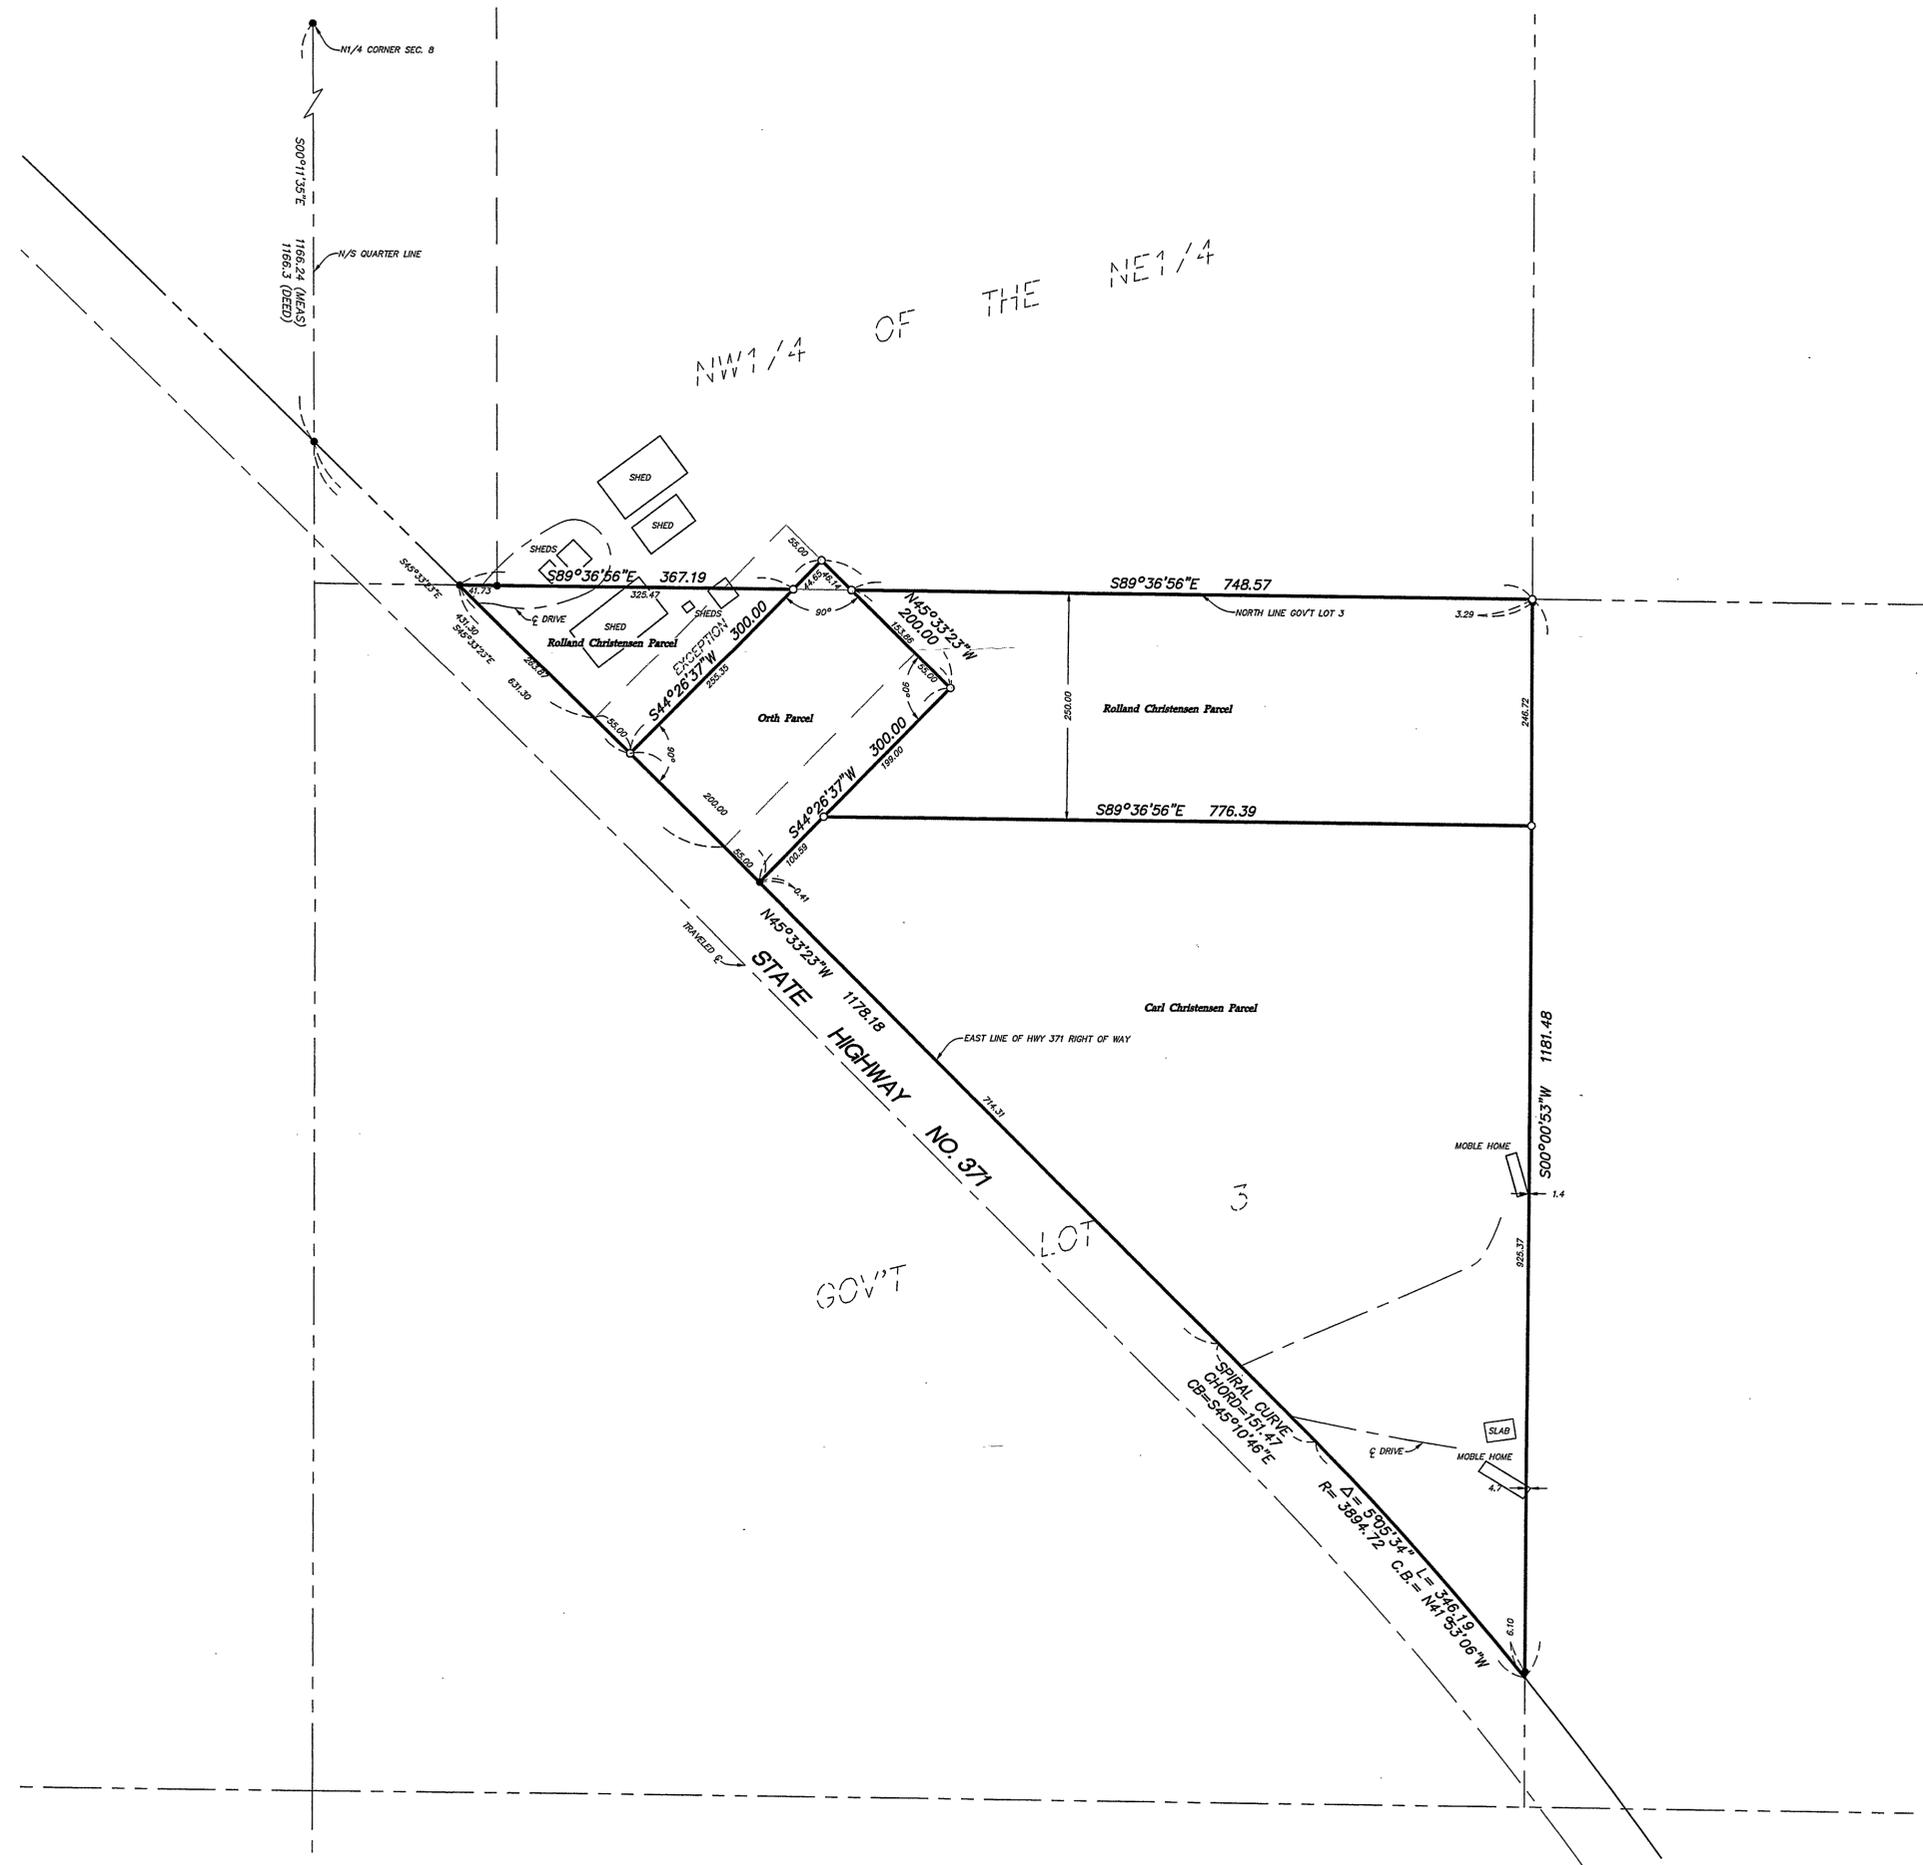

LEGAL DESCRIPTION: ORTH PARCEL (FURNISHED BY CLIENT)

That part of the Northwest Quarter of the Northeast Quarter (NW1/4NE1/4) and Government Lot 3, Section 8, Township 137, Range 29, described as follows: Commencing at the North quarter section corner of said Section 8, thence South on the quarter section line 1,166.3 feet, more or less, to the East line of the right of way of Highway #371; thence Southeast along said East line of the right of way of said Highway #371 a distance of 431.3 feet to the point of beginning of the premises to be conveyed herein; thence deflect left 90 degrees and run 300 feet to a point; thence deflect right 90 degrees and run 200 feet to a point; thence deflect right 90 degrees and run 300 feet, more or less, to said right of way line of Highway #371; thence deflect right and run 200 feet, more or less, along said East right of way line of said Highway #371 to the point of beginning.

AND ALSO THE FOLLOWING DESCRIBED TRACT:

That part of Government Lot 3 of Section 8, Township 137, Range 29 described as follows: Commencing at the North quarter section corner of said Section 8; thence South on the quarter section line 1,166.3 feet, more or less, to the East line of the right of way of Highway #371; thence Southeast along the said East line of the right of way of Highway #371, a distance of 631.3 feet to the point of beginning of the premises to be conveyed herein; thence deflect left 90 degrees and run 300 feet to a point; thence deflect right 90 degrees and run 300 feet, more or less, to the said East right of way line of said Highway #371; thence deflect right and run 55 feet along the said East right of way line of said Highway #371 to the point of beginning. The said tract being 55 feet wide by 300 feet deep.

EXCEPT THE FOLLOWING DESCRIBED TRACT:

That part of the Northwest Quarter of the Northeast Quarter (NW1/4NE1/4) and Government Lot 3, Section 8, Township 137, Range 29, described as follows: Commencing at the North quarter section corner of said Section 8, thence South on the quarter section line 1,166.3 feet, more or less, to the East line of the right of way of Highway #371; thence Southeast along the said East line of the right of way of Highway #371 a distance of 431.3 feet to the point of beginning of the premises to be conveyed herein; thence deflect left 90 degrees and run 300 feet to a point; thence deflect right 90 degrees and run 55 feet to a point; thence deflect right 90 degrees and run 300 feet, more or less, to the said East right of way line of said Highway #371; thence deflect right and run 55 feet along the said East right of way line of said Highway #371 to the point of beginning. Said tract of land being 55 feet wide by 300 feet deep.

LEGAL DESCRIPTION: ROLLAND CHRISTENSEN PARCEL

The North 250.00 of Government Lot 3, Section 8, Township 137 North, Range 29 West, Cass County, Minnesota, lying north and east of the right of way of State Highway No. 371. EXCEPT that tract of land described as follows: Commencing at the North quarter section corner of said Section 8, thence South on the quarter section line 1,166.3 feet, more or less, to the East line of the right of way of Highway #371; thence Southeast along said East line of the right of way of said Highway #371 a distance of 486.30 feet to the point of beginning of the premises to be conveyed herein; thence deflect left 90 degrees and run 300 feet to a point; thence deflect right 90 degrees and run 200 feet to a point; thence deflect right 90 degrees and run 300 feet, more or less, to said right of way line of Highway #371; thence deflect right and run 200 feet, more or less, along said East right of way line of said Highway #371 to the point of beginning.


LEGAL DESCRIPTION: CARL CHRISTENSEN PARCEL

Government Lot 3, Section 8, Township 137 North, Range 29 West, Cass County, Minnesota, lying north and east of the right of way of State Highway No. 371. EXCEPT the North 250.00 thereof and ALSO EXCEPT that tract of land described as follows: Commencing at the North quarter section corner of said Section 8, thence South on the quarter section line 1,166.3 feet, more or less, to the East line of the right of way of Highway #371; thence Southeast along said East line of the right of way of said Highway #371 a distance of 486.30 feet to the point of beginning of the premises to be conveyed herein; thence deflect left 90 degrees and run 300 feet to a point; thence deflect right 90 degrees and run 200 feet to a point; thence deflect right 90 degrees and run 300 feet, more or less, to said right of way line of Highway #371; thence deflect right and run 200 feet, more or less, along said East right of way line of said Highway #371 to the point of beginning.

NOTE: NO TITLE WORK WAS FURNISHED FOR THE PREPARATION OF THIS SURVEY.



- Denotes Set Iron Monument Capped RLS 17253
- Denotes Found Iron Monument

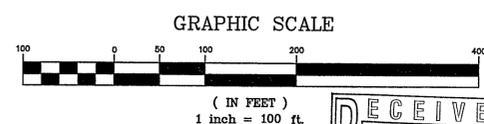

RECEIVED
 # 2242
 JUL - 6 2004
 NWME
 GLS 8-137-29
 CASS COUNTY SURVEYOR

Prepared By:

 Westwood Professional Services, Inc.
 411 Laurel Street
 Brainerd, MN 56401
 Phone: (218) 829-1751 Fax: (218) 829-4733

I hereby certify that this survey was prepared by me or under my direct supervision and that I am a duly licensed LAND SURVEYOR under the laws of the State of Minnesota.

 Bruce Grivna
 Date: 6/1/04 License No. 17253

Crew:
 Checked: BWG
 Drawn: CDH
 Record Drawing by/date:

Prepared for:
Mike Orth
 P.O. Box 364
 Pine River, Minnesota 56474

**Part of Section 8, T137N, R29W
 Cass County, MN**