


CERTIFICATE of SURVEY

BEING PART OF THE ~~E-NE~~ ^{NE} ~~1/4~~ ^{1/4} OF SECTION 20, TOWNSHIP 143 NORTH,
RANGE 26 WEST OF THE 5TH PRINCIPAL MERIDIAN
CASS COUNTY, MINNESOTA

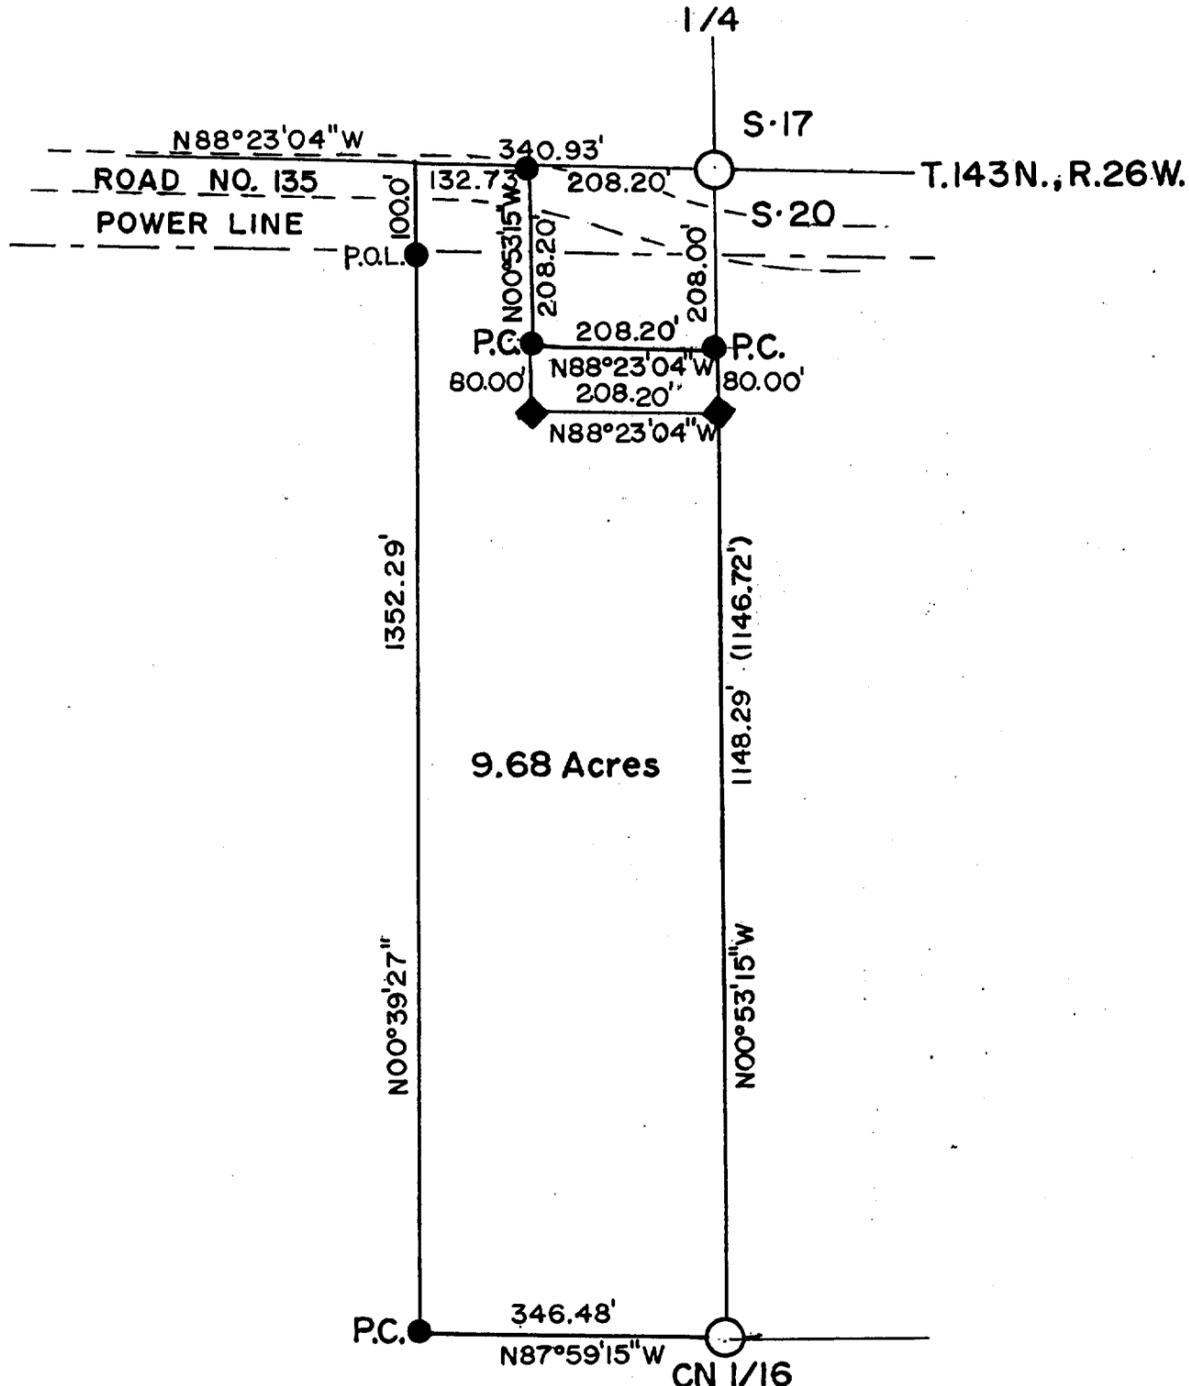

CN 1/16 B.T.'s
6" White Oak, N52°E, 17.86'
10" White Birch, S22°W, 44.66'
Steel Sign Posts, West & East,
3.0'

LEGEND

- - Found Forest Service Brass Capped Monument
- - Section Subdivision Corners
- - Brass Capped Monument
- - Set 1/2" x 24" Re-bar With Plastic Cap

P.O.L. - Point on Line
P.C. - Property Corner
SCALE: 1" = 200'

Bearings from Forest Survey on record in Cass County Courthouse.

Revised 9/10/04

◆ - added 80 feet on south side of one acre tract.

Surveyors Affidavit:

I, Milo E. Stefan, a Registered Land Surveyor in the State of Minnesota, and at the request of Jeff and Roxy Engelke, have surveyed and marked the East 9.68 acres of the NE ¹/₄ NW ¹/₄ Section 20, T143N, R26W with the 1.0 acre exception in the NE Corner of said tract. I certify that this plat drawing is a true and correct representation of the lands surveyed and marked to the best of my abilities.

Milo E. Stefan
Milo E. Stefan
RLS #12261

6/8/04
Dated

