
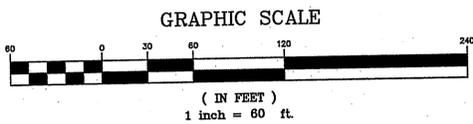


CERTIFICATE OF SURVEY

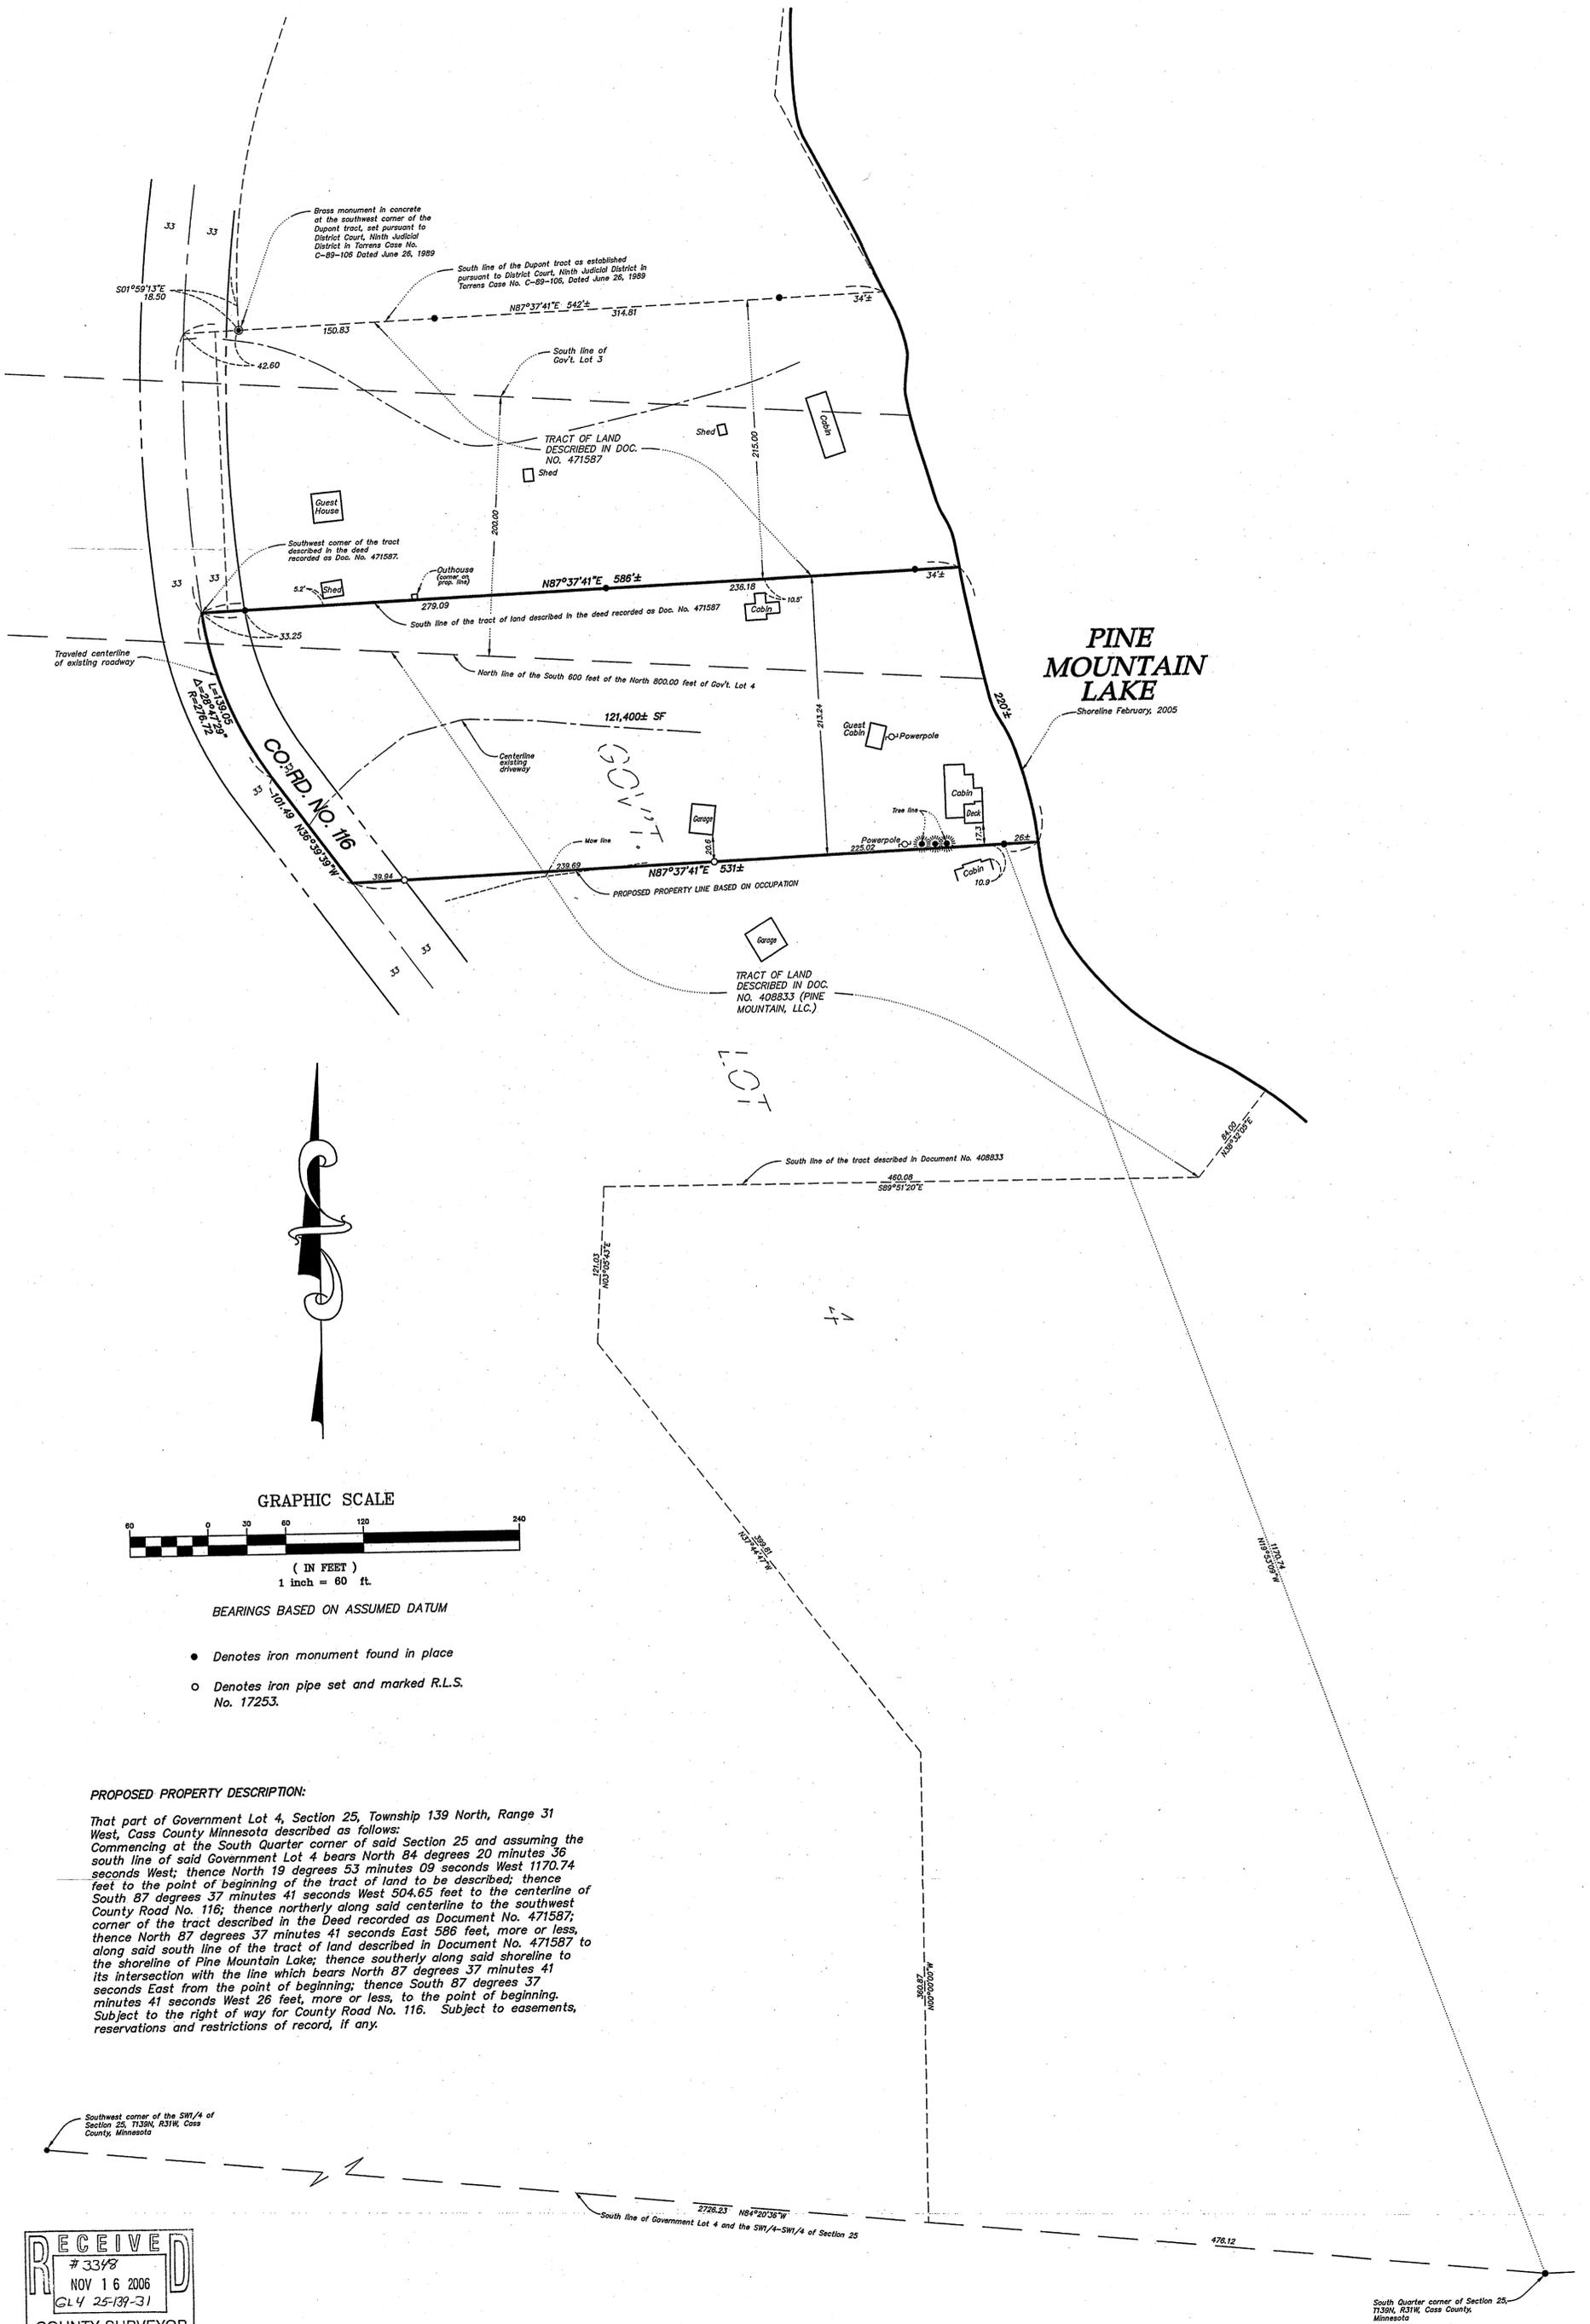


BEARINGS BASED ON ASSUMED DATUM

- Denotes iron monument found in place
- Denotes iron pipe set and marked R.L.S. No. 17253.

PROPOSED PROPERTY DESCRIPTION:

That part of Government Lot 4, Section 25, Township 139 North, Range 31 West, Cass County Minnesota described as follows:
 Commencing at the South Quarter corner of said Section 25 and assuming the south line of said Government Lot 4 bears North 84 degrees 20 minutes 36 seconds West; thence North 19 degrees 53 minutes 09 seconds West 1170.74 feet to the point of beginning of the tract of land to be described; thence South 87 degrees 37 minutes 41 seconds West 504.65 feet to the centerline of County Road No. 116; thence northerly along said centerline to the southwest corner of the tract described in the Dead recorded as Document No. 471587; thence North 87 degrees 37 minutes 41 seconds East 586 feet, more or less, along said south line of the tract of land described in Document No. 471587 to the shoreline of Pine Mountain Lake; thence southerly along said shoreline to its intersection with the line which bears North 87 degrees 37 minutes 41 seconds East from the point of beginning; thence South 87 degrees 37 minutes 41 seconds West 26 feet, more or less, to the point of beginning. Subject to easements, reservations and restrictions of record, if any.

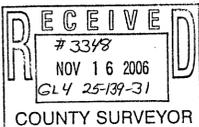

Prepared By:
Westwood Professional Services, Inc.
 411 Laurel Street
 Brainerd, MN 56401
 Phone: (218) 829-1751 Fax: (218) 829-4733

I hereby certify that this survey was prepared by me or under my direct supervision and that I am a duly licensed LAND SURVEYOR under the laws of the State of Minnesota.
 Bruce Grivna
 Date: 11/16/06 License No. 17253

Crew: BAN/KAY
 Checked: BWG
 Drawn: KPM
 Record Drawing by/Date:

Prepared for:

Orion Marks
 6710 4th St.
 Fridley, MN 55432

Part of Gov't. Lot 4, Section 25
 T139N, R31W, Cass Co., MN.